



BENSALEM TOWNSHIP

Building and Planning Department
2400 Byberry Road • Bensalem PA 19020
215-633-3644 • FAX 215-633-3653

Exhibit Z-4

Zoning Hearing Board

Appeal Number: 2014-405

Original

Township of Bensalem, Bucks County, Pennsylvania Notice of Appeal

Appeal is hereby made by the undersigned from the action of the Zoning Officer.

Check applicable item(s):

- ☐ Certification of Non-Conforming Use
- ☐ Application for Validity Challenge
- ☐ Administrative Officer in refusing my application for a building permit dated: _____
- ☐ Special Exception
- ☒ Variance from the terms of the Zoning Ordinance of the Township of Bensalem

RECEIVED

AUG 01 2014

BENSALEM TOWNSHIP
BUILDING AND PLANNING

Appellant Name: James Fox

Address: 6137 Edge Ave
Bensalem Pa 19020

Phone No. _____

Owner's Name: Same as Above

Address: _____

Phone No. _____

Attorney Name: _____

Address: _____

Phone No. _____

Interest of appellant, if not owners (agent, lessee, etc.): _____

1. Application relates to the following:

Check items if applicable:

☐

Use

☐

Lot Area

☐

Height

☐

Yards

☐

Existing Building

☐

Proposed Building

☐

Occupancy

☒

Other: (describe)

3' From Property line not 5'

2. Brief description of Real Estate affected:

Tax Parcel Number:

02-52-118

Location:

6137 Edge Ave

Lot Size:

Present Use:

Residential

Proposed Use:

same

Present Zoning Classification:

Present Improvement upon Land:

Shed

Deed recorded at Doylestown in Deed Book

139

Page

11

3. If this is an appeal to challenge, provide statement and/or basis for challenge to the validity of the zoning ordinance.

I Thought The minimum was 2' From Line + Built
The shed 3' From Line Then Found out it was 5'
From Prop line

4. If this is an Appeal from action of the Zoning Administrative Officer then complete the following:

Date Determination was made:

Your statement of alleged error of Zoning Administrative Office:

5. Specific reference to section of the Zoning Ordinance upon which application for special exception or variance is based (if special or variance is desired):

6. Action desired by appellant or applicant (statement of relief sought or special exception or variance desired):

To Be able to leave shed at 3' From Prop Line.
IT already sits on concrete Pier Footings and
Anchored. I am removing a 12' x 20' shed when Done

7. Reasons appellant believes board should approve desired action (refer to section or sections of ordinance under which it is felt that desired action may be allowed, and not whether hardship is (or is not) claimed, and the specific hardship.

8. Has previous appeal or application for special exception or variance been filed in connection with these premises?

☐ YES ☒ NO

Specifications of errors must state separately the appellant's objections to the action of the zoning administrative office with respect to each question of law and fact which is sought to be reviewed.

I, hereby depose and say that all of the above statements and the statements contained in any papers or plans submitted herewith, are true to the best of my knowledge and belief.

Ap

Date


7/31/14

Sworn to and subscribed before me this

31 day of July 200-2014


Notary Public


My commission expires:

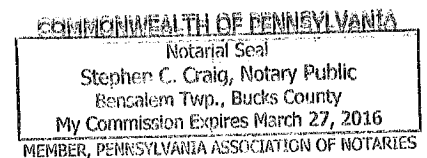

James Fox 6137 Edge Ave (215) 752-3956

Digging up broken 6'x14'10" front porch + replacing it with a 6'x28' front porch + extending porch roof to corner of house

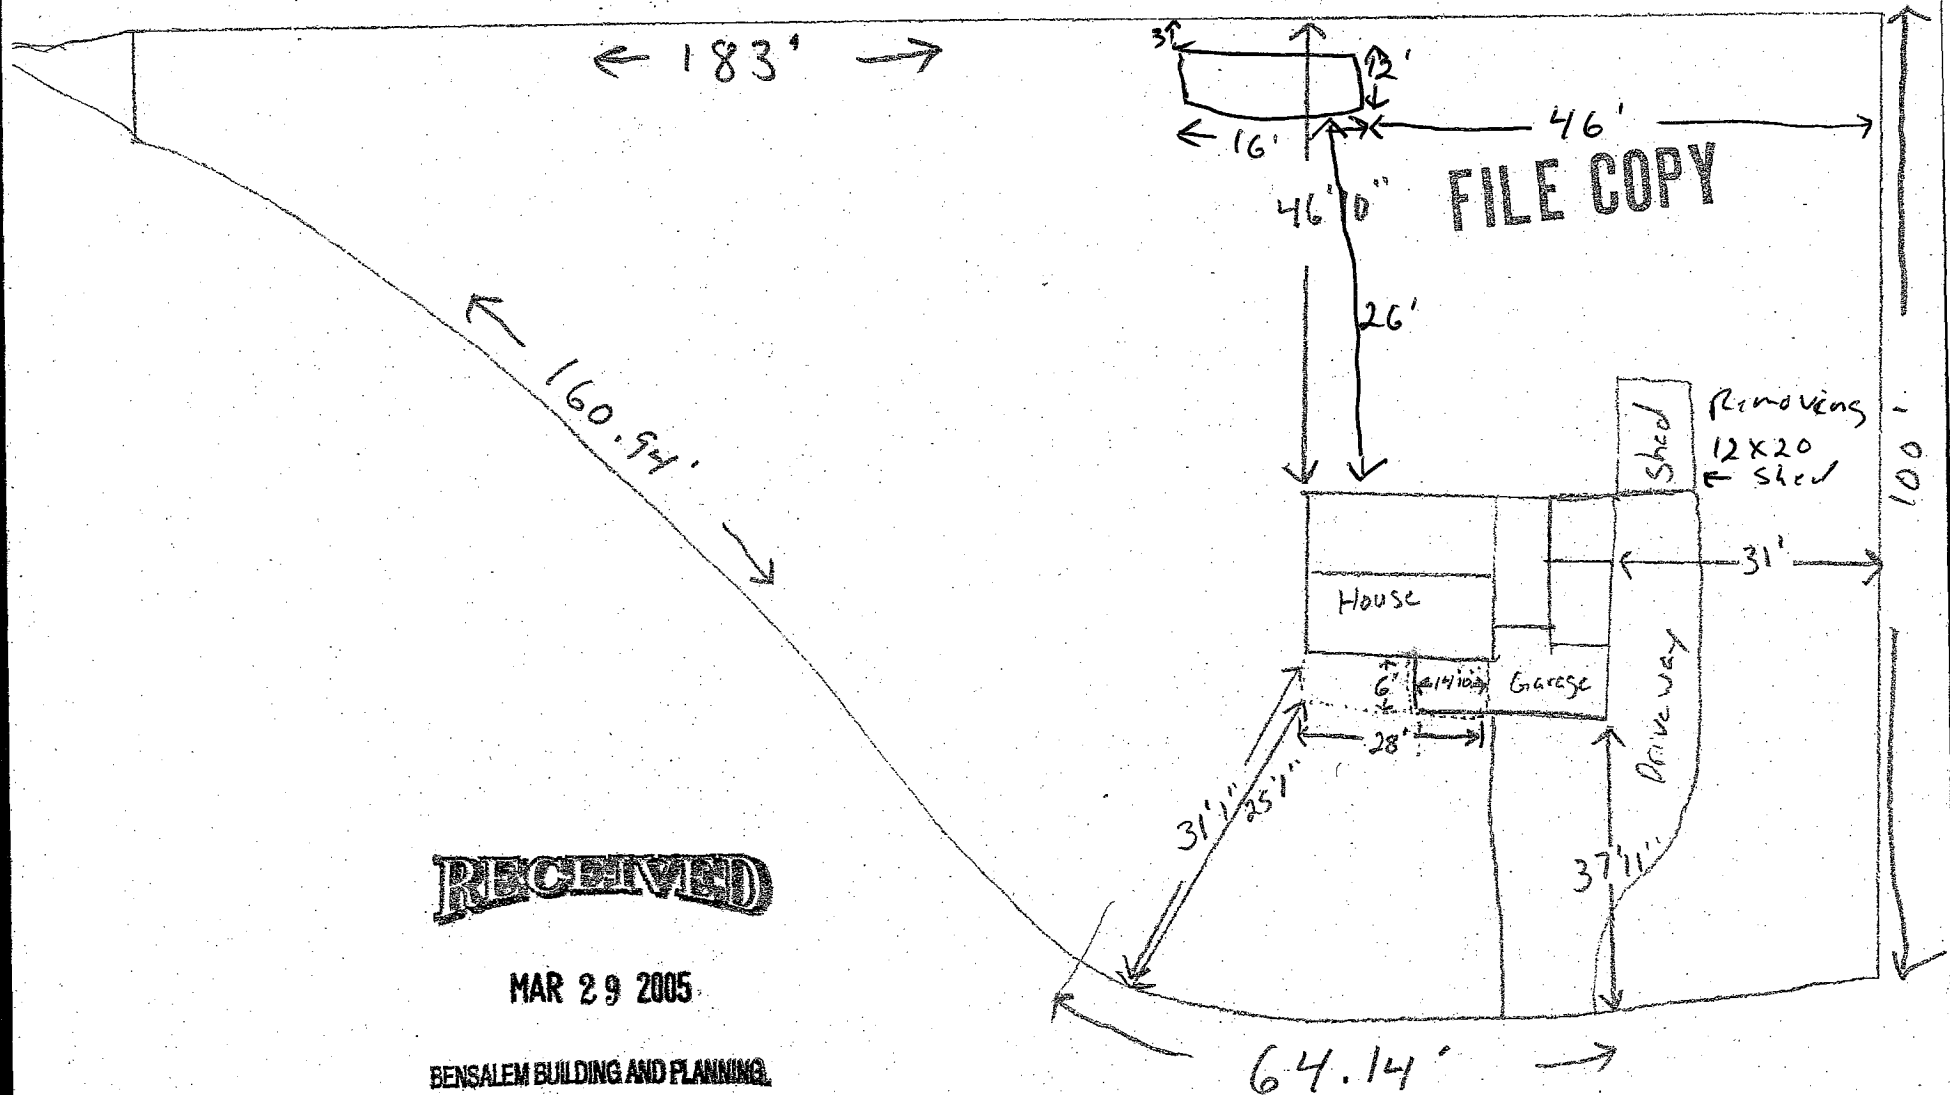

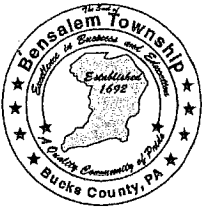

BENSALEM TOWNSHIP

Building and Planning Department

Office 215-633-3644 • Fax 215-633-3753

Matthew K. Takita

Director of Building and Planning

2400 Byberry Road • Bensalem, PA 19020

June 19, 2014

James Fox
6137 Edge Ave
Bensalem, PA 19020

Project:	SHED
Project Address:	6137 Edge Ave Bensalem, PA 19020
Tax Parcel:	02-52-118
Property Owner:	Same as addressed
Permit Status:	Application Denied

Electronic Review Status

Dear Sir/Madam:

A review was conducted on the application for the referenced project pursuant to Chapter 232 ZONING, [Section 232-583(a)(2)]. The attached sheets show what was found during the review and this information is required to complete the permit application for the above referenced project.

The review process utilizes Adobe Acrobat allowing reviewers to make their comments directly on the plan pages. These comments are tracked throughout the review and a printed summary serves as the basis for a rejection on the project until required changes have been made. The attached sheets will show an image of the plan page including its associated comments with connector lines. Only those pages of the plans that require a revision have been generated and included.

You are required to resubmit plans with revisions and will need to burn the **complete** set of plans with revisions to a new disc. Return it to the Building & Planning Department. You are to include a summary list of **all** changes that were made to the plans including those required by the Township. For each change made to the plans, note the sheet number, drawing title, and a brief description of the change made. Please label the disc with the project address, date and revision number to distinguish it from any earlier submissions.

It is our intent that you receive as few rejections as possible and provide reviewers a more efficient method for completing the review by utilizing the comments summary. The print dialog box should include the following summary options:

- Layout - Document and comments with connector lines on single pages
- Font Size - Large font size
- Include - all comments
- **Clear** - the checkbox to NOT include pages containing no comments

It is possible that upon receipt of the revised plans, additional items for compliance may be required. This letter shall serve as formal notice that your permit application has been rejected for said project until such time as the requested information has been provided.

You have the right to appeal this rejection letter. Applications for the Zoning Hearing Board can be obtained from the Building and Planning Department located in the Municipal Building at 2400 Byberry Road, Bensalem.

Respectfully,


Harold W. Gans, P.E., P.L.S.
Township Engineer

HWG/lva
Enclosures

91-7199-9991-7033-6363-1910
Certified and Regular Mail




Summary of Comments on 20140612_122246.pdf

Page: 5

 Number: 1 Author: rgans Subject: Callout Date: 6/19/2014 2:19:07 PM

Must be 5 ft minimum
[Section 232-583(a)(2)]

 Number: 2 Author: rgans Subject: ZONING REJECTION Date: 6/19/2014 2:19:21 PM

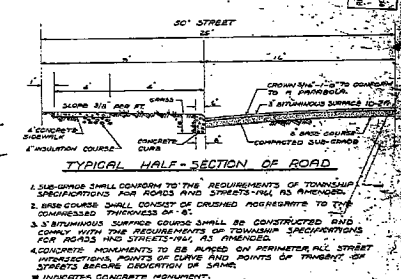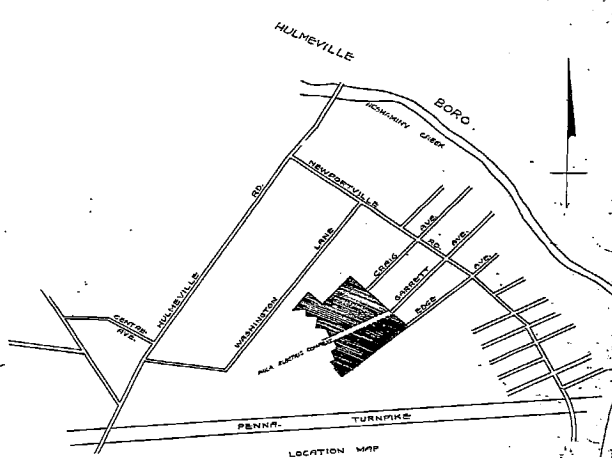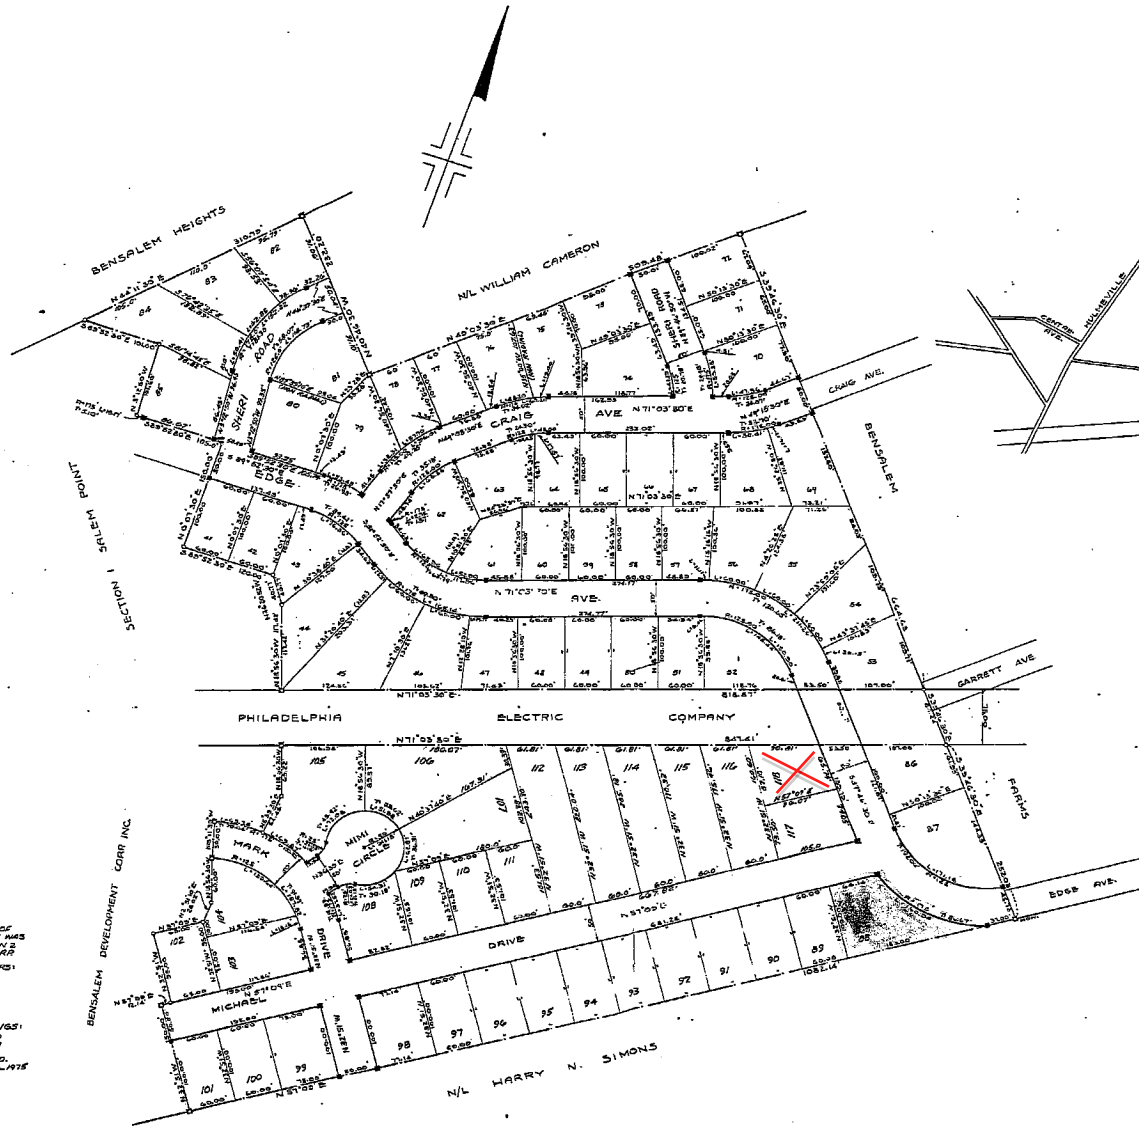

AT A MEETING OF THE BENSALLEN TOWNSHIP BOARD OF SUPERVISORS HELD, ON THE 22ND DAY OF DECEMBER, 1977, IT WAS RESOLVED THAT THE "PLAN OF SALEM POINT" SECTION 2 BE RECORDED IN THE BENSALLEN DEVELOPMENT CORP. RECORDS.

TO ALL TO WHOM THESE PRESENTS SHALL COME WE BENSALLEN DEVELOPMENT CORP. INC. SENDS GREETINGS AND WISHES THAT WE HAVE Laid OUT A TRACT OF LAND WITHIN BENSALLEN TOWNSHIP, BUCKS COUNTY, PENNSYLVANIA, BE RECORDED IN THE BENSALLEN DEVELOPMENT CORP. RECORDS.

IN WITNESS WHEREOF, I HAVE HEREUNTO SET MY HAND AND SEAL OF OFFICE, THIS 22ND DAY OF DECEMBER, 1977.

ATTEST: JAMES H. HULL, JR., SECRETARY

APPROVED BY THE BENSALLEN TOWNSHIP BOARD OF SUPERVISORS, THIS 22ND DAY OF DECEMBER, 1977.

APPROVED BY THE BENSALLEN TOWNSHIP BOARD OF SUPERVISORS, THIS 22ND DAY OF DECEMBER, 1977.

APPROVED BY THE BENSALLEN TOWNSHIP BOARD OF SUPERVISORS, THIS 22ND DAY OF DECEMBER, 1977.

APPROVED BY THE BENSALLEN TOWNSHIP BOARD OF SUPERVISORS, THIS 22ND DAY OF DECEMBER, 1977.

NOTE: BUILDING STRUCK LINE TO BE 21" WIDE, SUBJECT TO ALL EASEMENTS OF RECORD.

THIS PLAN RECORDED IN THE RECORDS OF DEEDS OFFICE FOR THE COUNTY OF BUCKS BY THE UNDERSIGNED AS SHOWN.

SECTION 2	
SALEM POINT	
BENSALLEN DEVELOPMENT CORP. INC.	
BENSALLEN, TWO BUCKS CO. PA.	
0 50 100 150 200	
RECORDED	DATE
PLAT IN	SCALE